


AS BUILT DRAWING

For A Pressure Distribution Septic System With a Pressure Drainfield @ 470 N. 50th Avenue

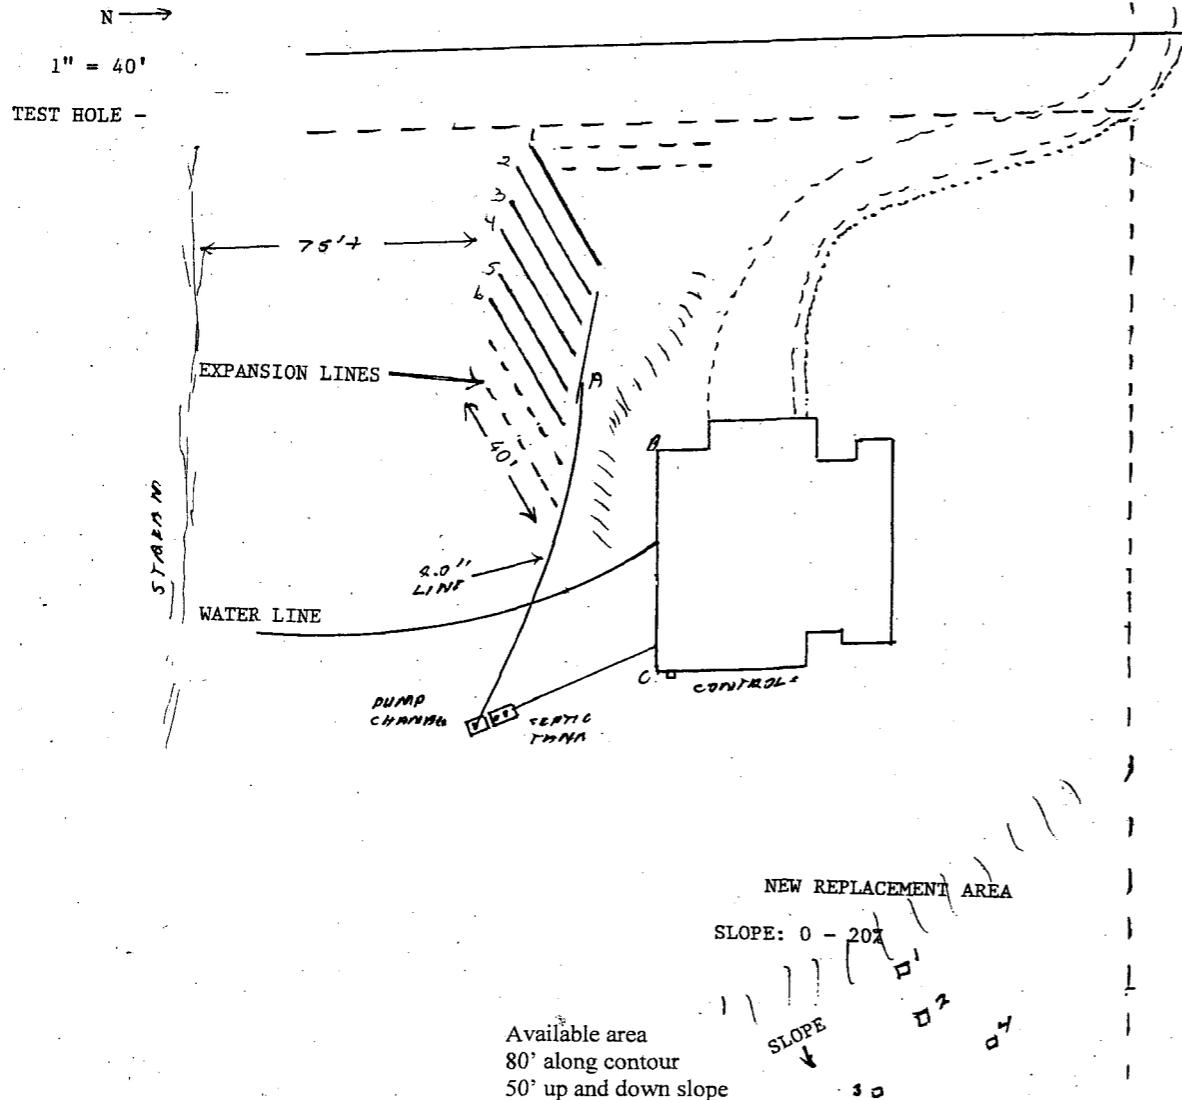


Designers Certification

System is installed satisfactory.

Swing Ties; A - B 39'

A - C 81'

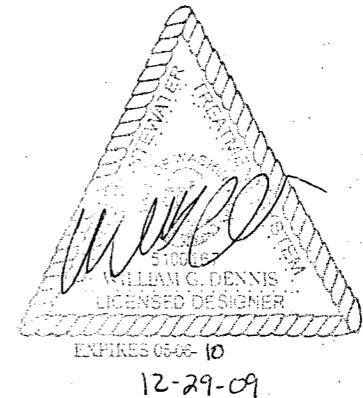

ENVIRONMENTAL
 HEALTH UNIT
 FINAL APPROVAL
 DEC 30 2009
 COWLITZ COUNTY
 BUILDING & PLANNING

VALUING DETAIL

