



STATE OF WASHINGTON
DEPARTMENT OF ECOLOGY

15 West Yakima, Suite 200 • Yakima, Washington 98902 • (509) 575-2490

February 6, 2002

Jose Cervantes
Cervantes Orchards
5881 Bethany Rd
Sunnyside WA 98944

RE: Reporting Provisions on Emergency Drought Permits

Dear Mr. Cervantes,

Thank you for your response to Phil Crane's letter dated January 29, 2002. We are happy to submit for your perusal a summary of the Yakima Basin 2001 Emergency Drought Permits water use. Please find the enclosed summary. With the exception of your data, the summary was complete in late December, 2001.

Please clarify some of the statements made in your response:

1. Are we to understand that the new wells requested under Permit No's. G4-37818, G4-34521 and G4-34522 have not been drilled?
2. What is the total amount of water used under No. G4-34517?
3. What is the total amount of water used under No. G4-34519?
4. What is the total amount of water used under No. G4-34520?

Your immediate attention to these questions is appreciated.

Sincerely,

Suzanne Blakeney
Water Resources Program

SB:gg
020209

Enclosures: 2001 Drought Water Use Spreadsheet

FILE COPY



STATE OF WASHINGTON
DEPARTMENT OF ECOLOGY

4000 1st Avenue, Suite 200, Tacoma, Washington 98902-3450 • (509) 575-2100

I received a call from Potts at the end of Oct. 15 2001 concerning any of this wells because the permits were for 2001 irrigation season

January 29, 2002

*64-34521 Arrow Smith/Stout
64-34518 Holmiston
64-34522 SULFUR CREEK*

Jose Cervantes
Cervantes Orchards
5881 Bethany Rd
Sunnyside WA 98944

64-34519 in this property once they start now could we get 45500 GPM seepage we have a 75 HP pump to irrigate

RE: Reporting provisions on Emergency Drought Permits

025128 THIS WAS USED 14 DAYS 250 GPM 60%

As of this date, you have been contacted nine times requesting meter readings on the six Emergency Drought Permits in your name. A letter dated November 16, 2001 asked for the meter readings that were provisions of *all* Emergency Drought Permits. Please be advised that your continued non-compliance may result in monetary penalties for failing to live up to the conditions of your Emergency Drought Permits.

Ecology's drought report to the Bureau of Reclamation concerning water use under the drought permits has been delayed for 3 weeks waiting for your data. You are the only drought water user that has not complied with the reporting requirements.

on this comment I like to see this info Joe

Please submit the requested data by Friday, February 1, 2002.

If you have questions, please give me a call at (509) 454-7647.

Sincerely,

Phil Crane, Operations Unit Supervisor
Water Resources Program
Central Regional Office

I talked to a lady a few times but 9 times I mentioned that the guy in charge was in vacation

Joe

PC:gg
020143


cc: Permit File

FRANK ANDERSON

CERVANTES ORCHARDS

Pipe / Sprinkler / Valve Key

- 8" Class 125 IPS GSK PVC Pipe
- 6" Class 125 IPS GSK PVC Pipe
- 5" Class 125 IPS SW PVC Pipe
- 4" Class 125 IPS SW PVC Pipe
- 3" Class 125 IPS SW PVC Pipe
- 2" Class 125 IPS SW PVC Pipe
- 1 1/2" Class 125 IPS SW PVC Pipe
- 1 1/4" Class 125 IPS SW PVC Pipe
- 1" Class 200 IPS SW PVC Pipe
- 3/4" Class 200 IPS SW PVC Pipe
- ∇ 2" AIR/VACUUM VALVE
- ⊗ 2" PVC BALL VALVE ABOVE GROUND
- ∇ 1" AIR/VACUUM VALVE
- ⊗ 3/4" Drain Valve ASSEM. MAINS-SUBS.
- LOST MISC. HYDRAULIC ITEM
- ⊗ 4" Tuf-skin Butterfly GEAR OPERATED
- ⊗ Water Supply

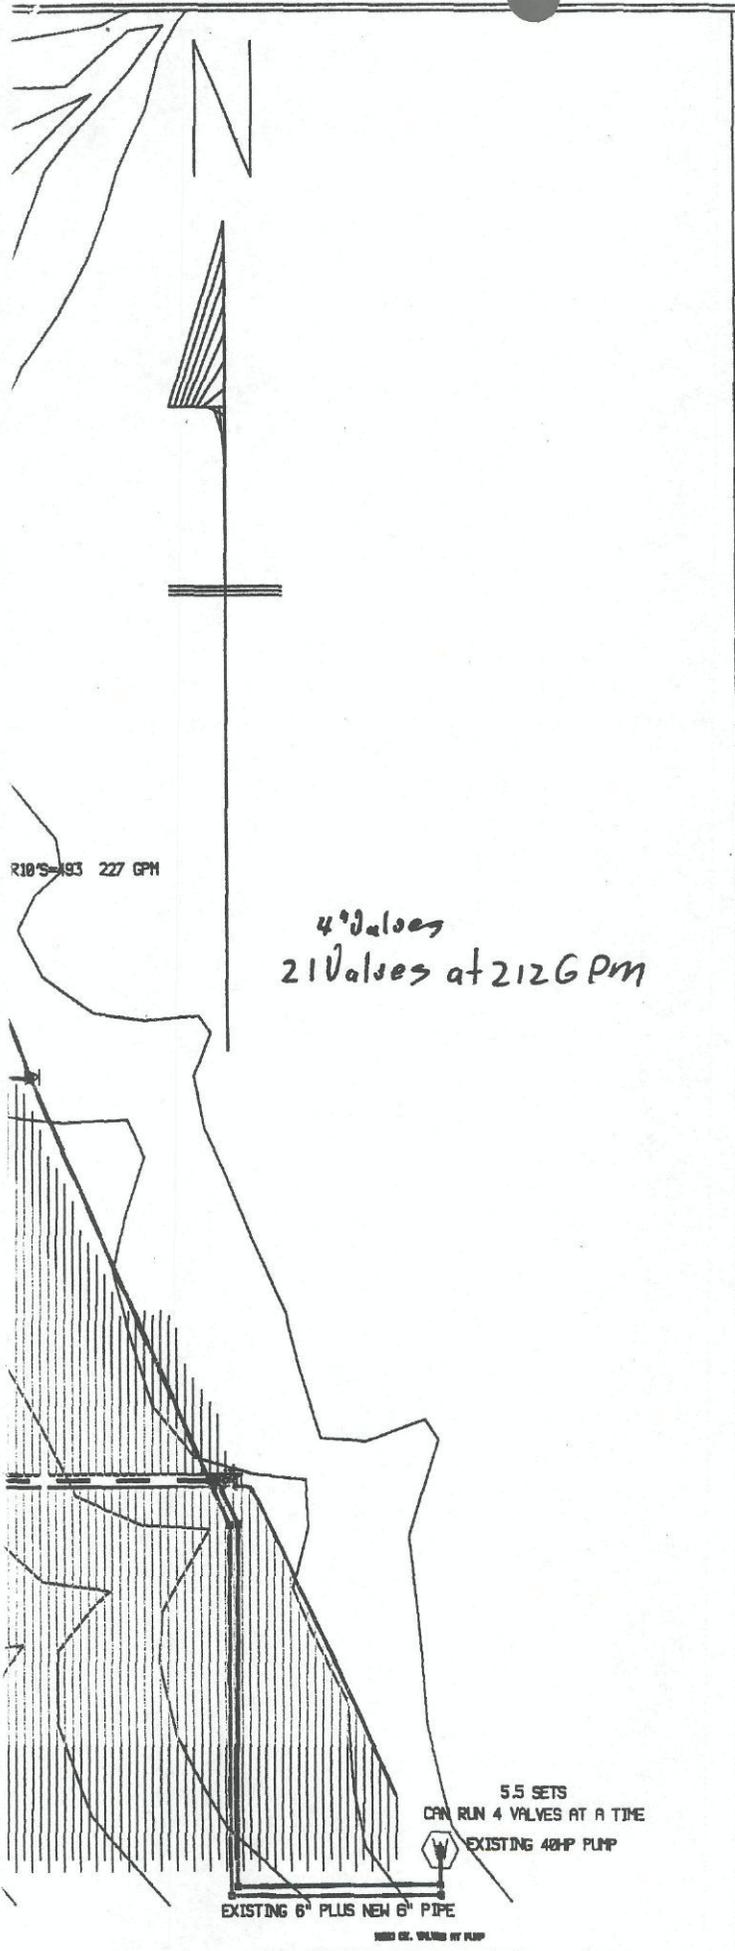

R10'S-193 227 GPM

4 Valves
21 Valves at 212 GPM

1 Valve 285 GPM

Frank L Anderson

646 34520

35 acres - 1 Valve 285 GPM

50% we irrigated
the block and stopped
and irrigate again

5.5 SETS
CAN RUN 4 VALVES AT A TIME
EXISTING 40HP PUMP
EXISTING 6" PLUS NEW 6" PIPE
5.5 G.P. VALVES BY PUMP

Designer: FRANK ANDERSON

Date: 12\95

Scale: 1" = 310'

Design No. 13092

2" valves
5-Valves at 576pm
each
or 285 GPM
1-set

EXIST. PIPE MUST BE AS SHOWN OR LARGER
TO RUN AS ONE SET

CHERRIES 16X8 R10'S 16X32
#50 NOZ. 40 PSI 40 GPM/AC
4 VALVES

R10'S-619 254 GPM

POND

R10'S-506 232 GPM

APPLES 13X4 R10'S 13X40
#55 NOZ. 40 PSI 47 GPM/AC
18 VALVES

R10'S-508 233 GPM


R10'S-368 209 GPM

R10'S-368 209 GPM

EXISTING PIPE


R10'S-368 209 GPM

R10'S-368 209 GPM

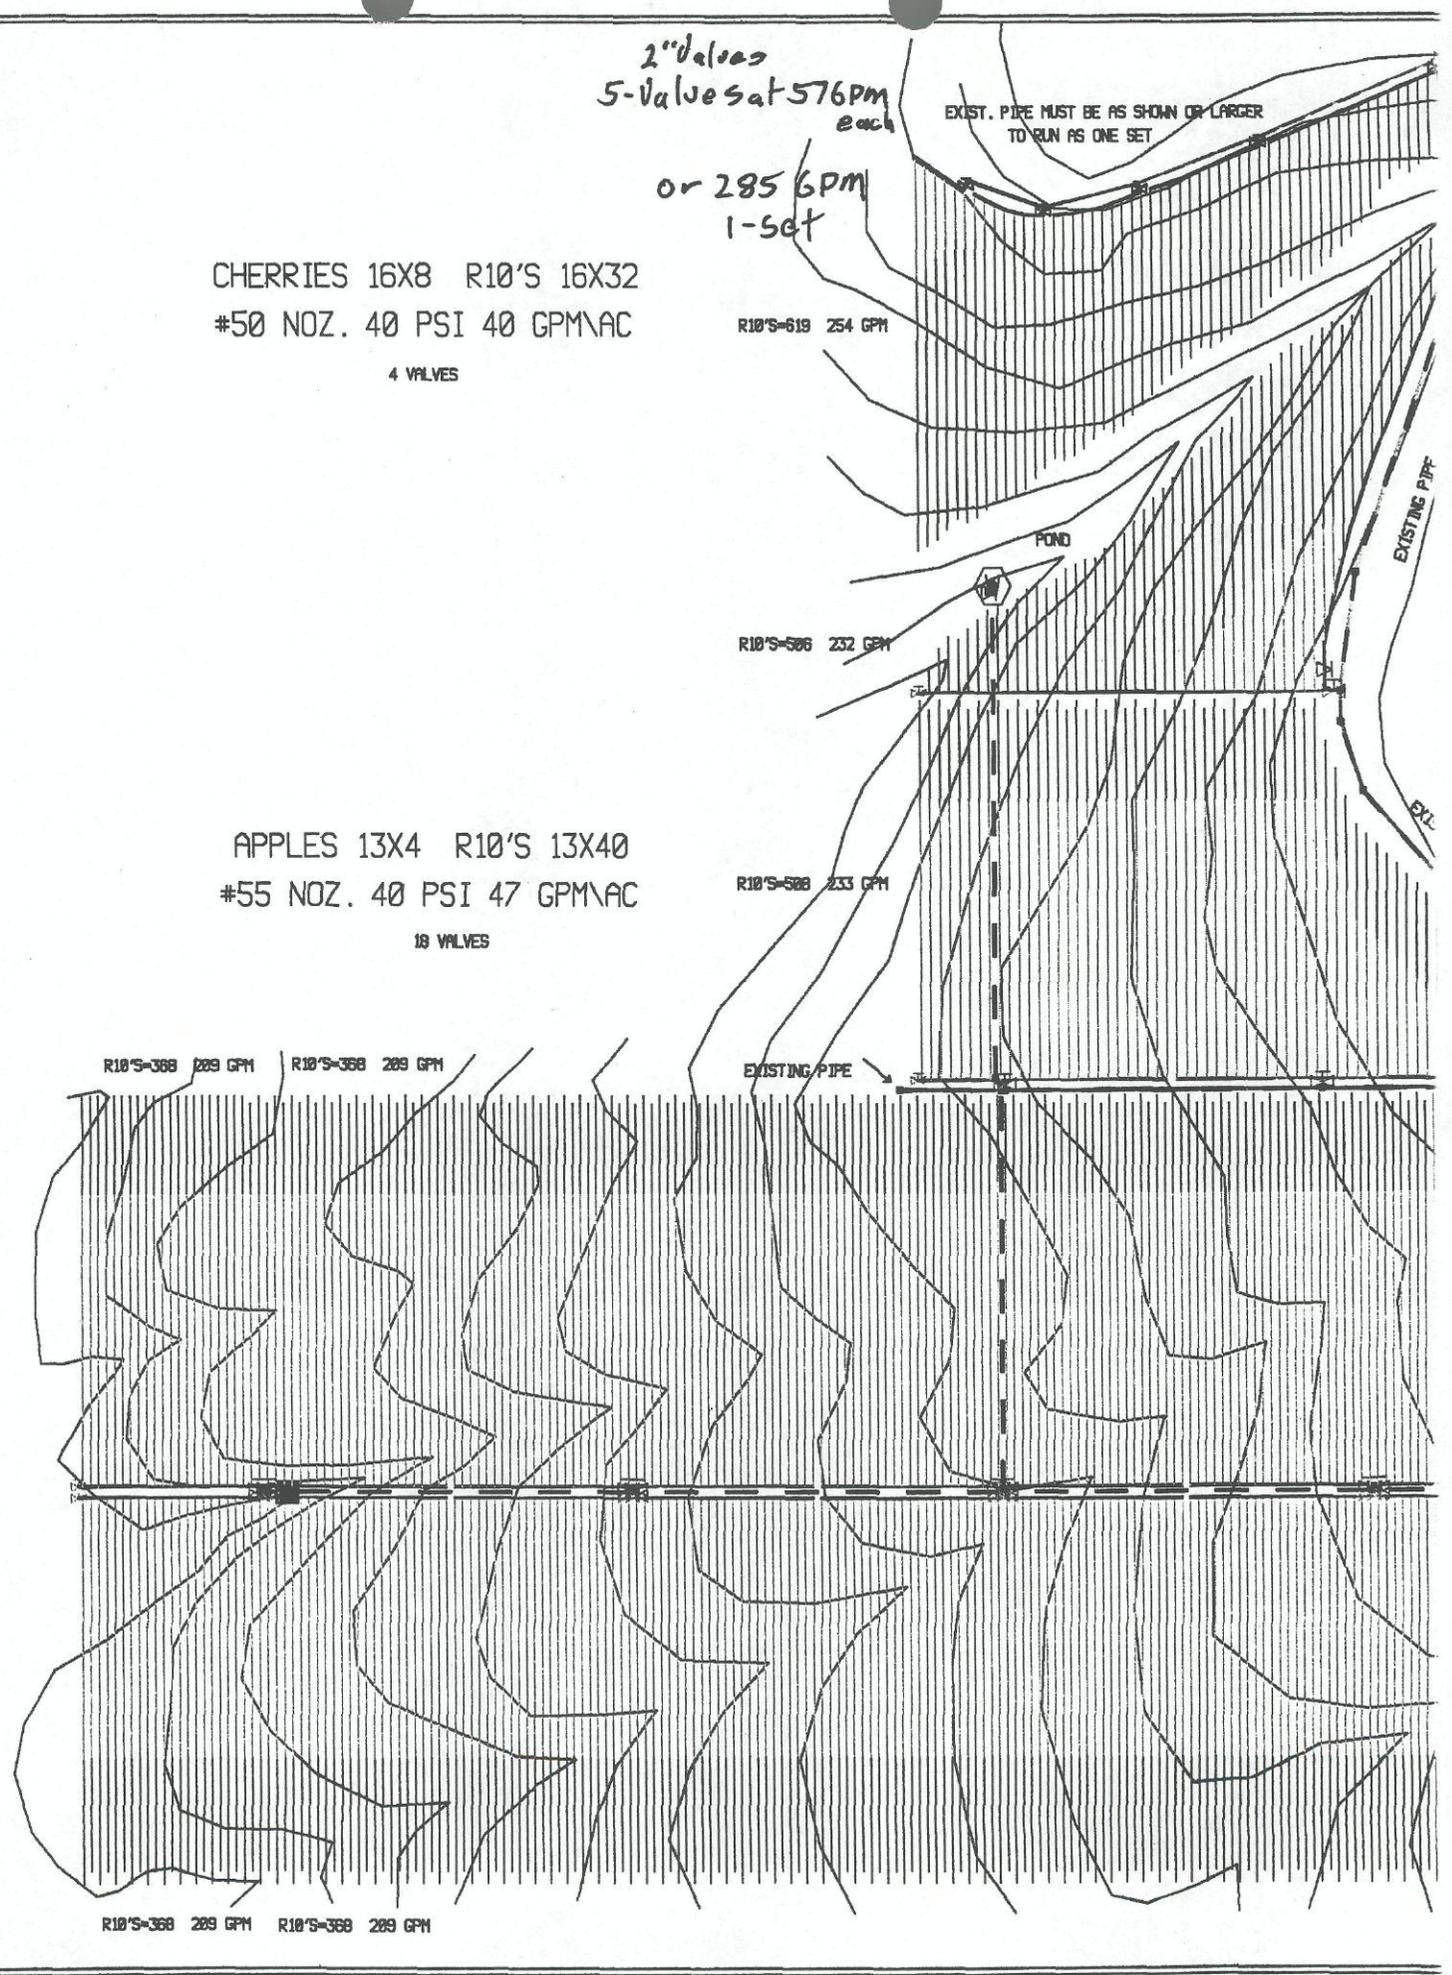

FRANK ANDERSON

J. CERVANTES SEC26-10-23

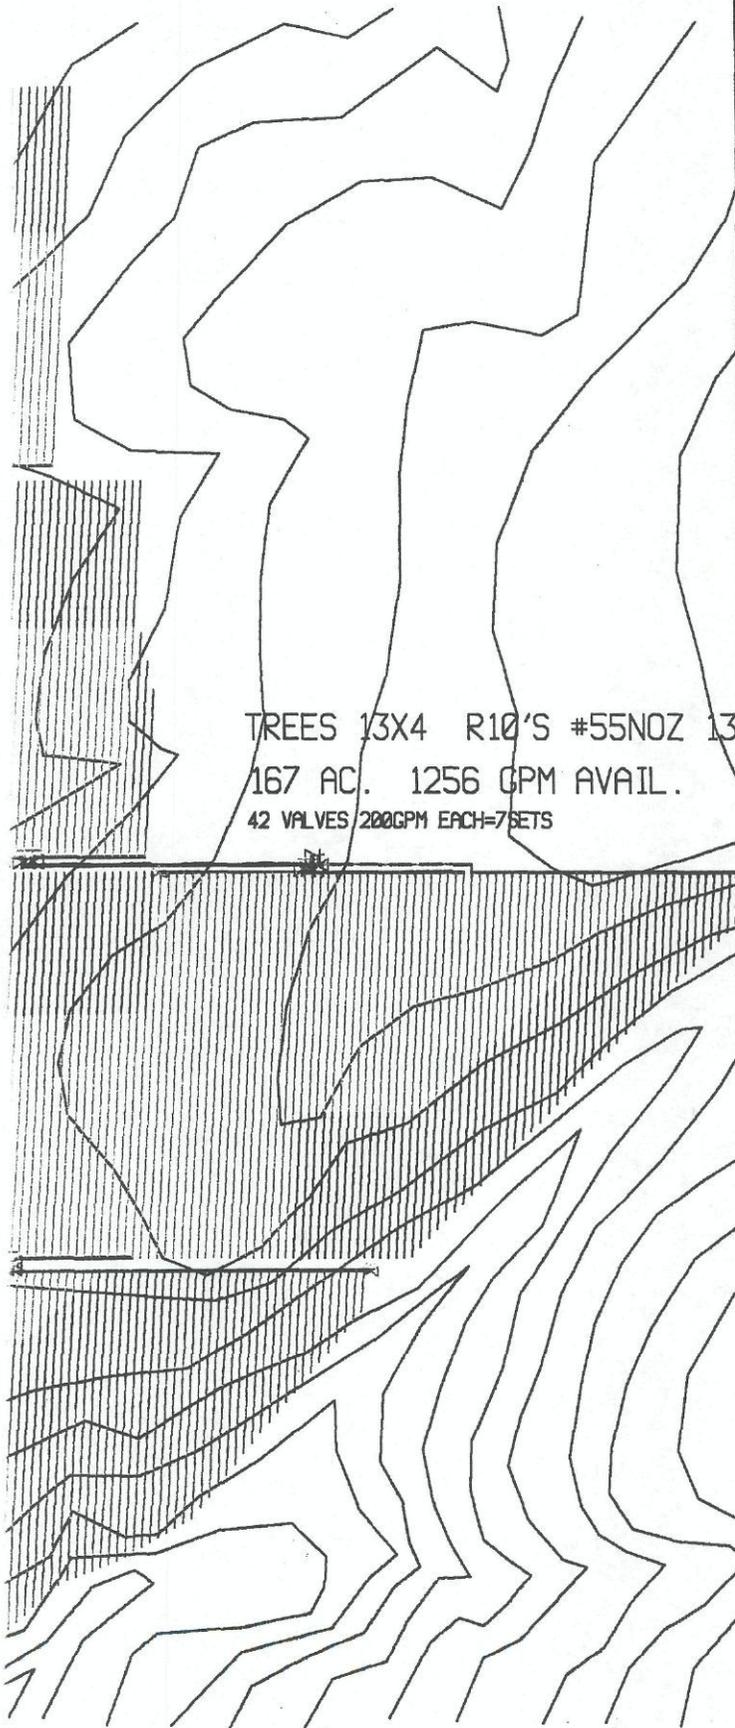

Pipe / Sprinkler / Valve Key

- 8" Class 125 IPS GSK PVC Pipe
- 6" Class 125 IPS GSK PVC Pipe
- 4" Class 125 IPS SW PVC Pipe
- 3" Class 125 IPS SW PVC Pipe
- 2" Class 125 IPS SW PVC Pipe
- 1" Class 200 IPS SW PVC Pipe
- 3/4" Class 200 IPS SW PVC Pipe
- 1/2" Class 315 IPS SW PVC Pipe
- 12" Class 125 IPS SW PVC Pipe
- ⊗ 2" AIR/VACUUM VALVE
- ⊙ 2" SURGE VALVE
- ⊗ 3/4" Drain Valve ASSEM. MAINS-SUBS.
- ⊗ 4" Tuf-skin Butterfly GEAR OPERATED
- ⊗ 3" Tuf-skin Butterfly Gear Operated
- ⊗ Water Supply

185 GPM/Valve

2 Values = 370 GPM

Frank Anderson

G 4-34517

113.7 acre


28 days 1 valve
 185 GPM
 50%
 We irrigated the block
 and stopped and irrigate
 again

Designer: ANDERSON

Date: 10\96

Scale: 1" = 310'

Design No. 20000

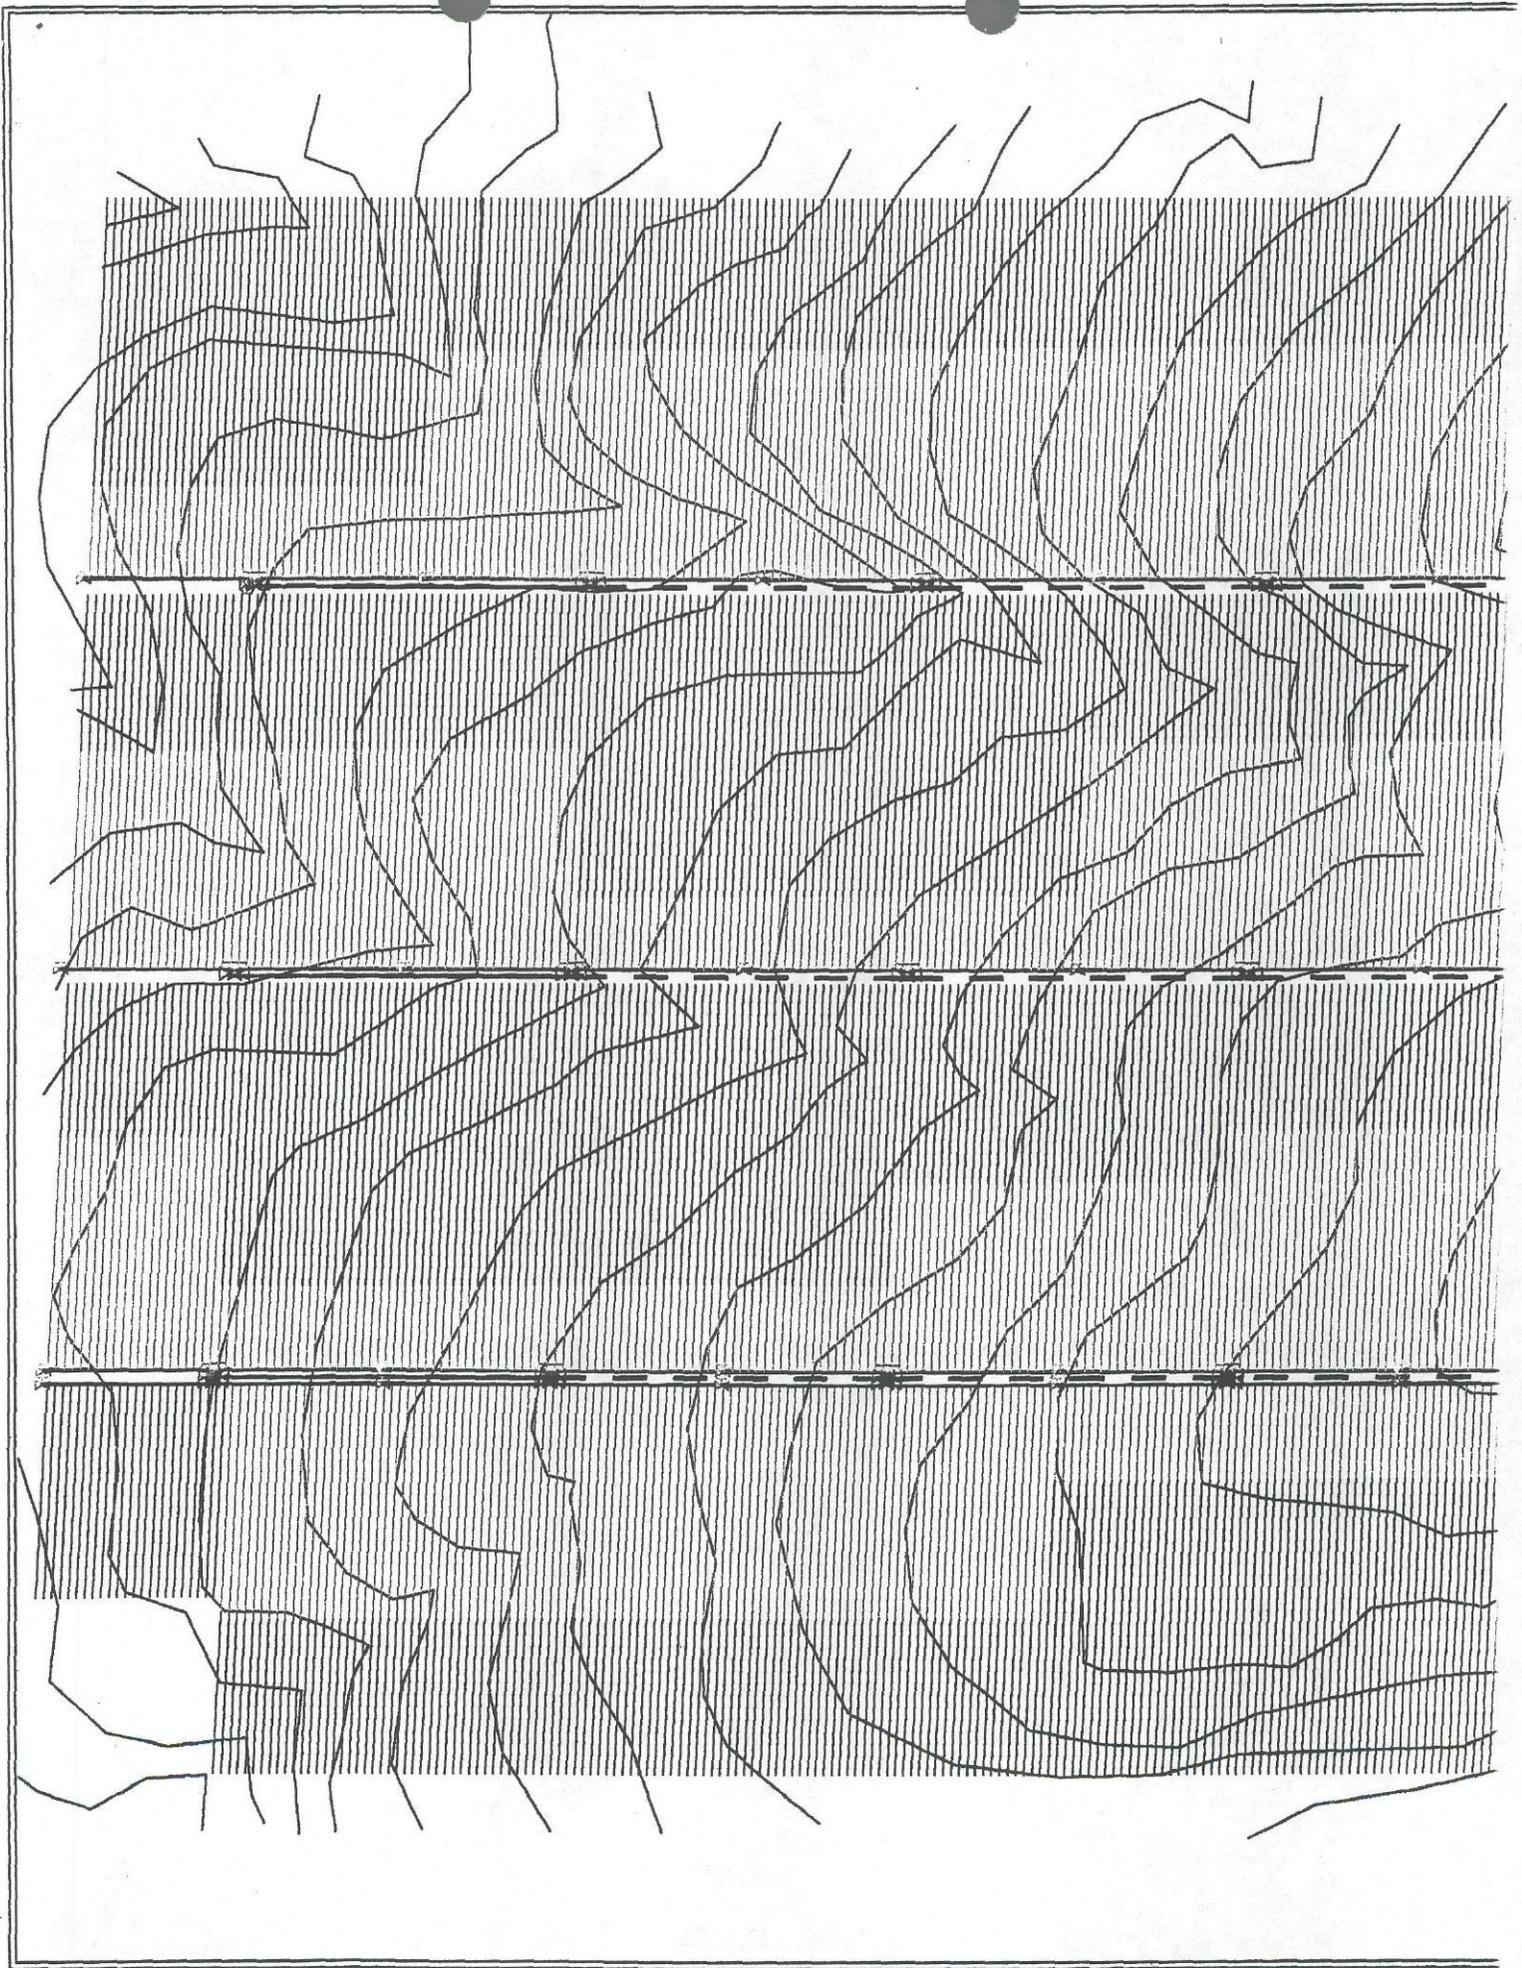



STATE OF WASHINGTON
DEPARTMENT OF ECOLOGY

15 West Yakima, Suite 200 • Yakima, Washington 98902 • (509) 575-2490

February 6, 2002

Jose Cervantes
Cervantes Orchards
5881 Bethany Rd
Sunnyside WA 98944

RE: Reporting Provisions on Emergency Drought Permits

Dear Mr. Cervantes,

Thank you for your response to Phil Crane's letter dated January 29, 2002. We are happy to submit for your perusal a summary of the Yakima Basin 2001 Emergency Drought Permits water use. Please find the enclosed summary. With the exception of your data, the summary was complete in late December, 2001.

Please clarify some of the statements made in your response:

1. Are we to understand that the new wells requested under Permit No's. G4-37818, G4-34521 and G4-34522 have not been drilled?
2. What is the total amount of water used under No. G4-34517?
3. What is the total amount of water used under No. G4-34519?
4. What is the total amount of water used under No. G4-34520?

Your immediate attention to these questions is appreciated.

Sincerely,

A handwritten signature in cursive script that reads "Suzanne Blakeney".

Suzanne Blakeney
Water Resources Program

SB:gg
020209

Enclosures: 2001 Drought Water Use Spreadsheet

FILE COPY

12/31/01

~~for~~ the 3rd time

Mr. Jose Cervantes was called today @ 1009 to remind him to submit his meter readings. He said they will be submitted early next week (week of 1/7/02) when his employee returns from vacation.

~~He~~ Mr. Cervantes wanted to know if he was being singled out in this regard, that "Ecology has been on [his] ass" and he wanted to know if that was the case for everyone.

I reminded him that ^{metering &} reporting is part of the provisions of his permits.

J. Blakewey



STATE OF WASHINGTON

DEPARTMENT OF ECOLOGY

15 West Yakima Avenue, Suite 200 • Yakima, Washington 98902-3452 • (509) 575-2490

November 16, 2001

Jose Cervantes
Cervantes Orchards
5881 Bethany Rd
Sunnyside WA 98944

RE: Application No(s). G4-34517, G4-34518, G4-34519, G4-34520, G4-34521, G4-34522

Earlier this year, the Department of Ecology issued an Emergency Drought Authorization under the above-referenced application number for the use of emergency wells in the Yakima River basins to supplement reduced deliveries during this irrigation season. In some cases new wells were approved for this purpose.

One of the provisions of the authorizations was that a flow meter must be installed, water use monitored, and the water use records submitted to the department at the end of the irrigation season. At this time, I am writing to request the metering reports on these wells. If you did not drill a well that was authorized, or did not use water that was authorized, please let us know.

My staff will be conducting end of irrigation season field visits in the near future. Your meter records and information on the completion of new wells is greatly appreciated.

If you have questions, please call Suzanne Blakeney at (509) 454-7294.

Sincerely,

Phil Crane, Unit Supervisor
Water Resources Program

SB:PC:gg
011110a



11-9-2001

Jose Cervantes was informed by me, that those wells authorized under the 2001 emergency permits could not be constructed after October 31, 2001.

Also Joshua Cannon of C&W Drilling was informed that they could not construct any of these wells under the emergency permits after October 31, 2001.

Genevieve

CERVANTES

64-34522

EXISTING DOMESTIC

NEW IRR WELL (IF NEEDED)

64-34521

EXISTING DOMESTIC

PROPOSED IRR WELL

USING 2 WELLS

SHERRY

OF Farm Services

454-5746 ext 103

She has copy of EDR dated 9-7-01 & needs to know for funding purposes - so he putting in a new well or using existing?

I looked at them & wrote the above. I didn't know what to tell her about 34522.

Can you call her back & answer her.

Ja

09-11-01

3:45