

FEE PAID

\$110.00
KJ

RECEIVED

JUN - 7 1994

DEPT. OF ECOLOGY

STATE OF WASHINGTON
DEPARTMENT OF ECOLOGY
I have examined this application as required by SEPA and find that it is: not an "action".

APPLICATION FOR PERMIT
TO CONSTRUCT A RESERVOIR AND TO STORE FOR BENEFICIAL USE
THE UNAPPROPRIATED WATERS OF THE STATE OF WASHINGTON

6/24/94
DATE

\$10.00 MINIMUM STATUTORY FILING FEE REQUIRED WITH APPLICATION
(GRAY BOXES FOR OFFICE USE ONLY)

+100.00 until July 1, 94
RB

APPLICATION NUMBER R1-27482	W.R.I.A. 5	COUNTY Snohomish	PRIORITY DATE 6-7-94	TIME	ACCEPTED [Signature]
APPLICANT'S NAME J JOSEF BEJVL				TELEPHONE NUMBER 483-1120, 972-0695	
DATE AND PLACE OF INCORPORATION IF APPLICANT IS A CORPORATION					
ADDRESS (STREET) 3511 240th S.E.		(CITY) Bothell	(STATE) Washington	(ZIP CODE) 98021	

1. SOURCE, USE, AND CAPACITY OF RESERVOIR

NAME OF PROPOSED RESERVOIR
safety pond - fire

NAME OF STREAM OR OTHER SOURCE FOR RESERVOIR SUPPLY
none

TRIBUTARY OF
springs 500-1000 yrds. uphill

USE(S) TO BE MADE OF IMPOUNDED WATER (IRRIGATION, POWER, FISH PROPOGATION, ETC.)
Protection- fire hazard area-helicopter pickup water-fish-maybe future power

NUMBER OF ACRE FEET TO BE STORED AT MAXIMUM OPERATING LEVEL
2 3/4 - 3 acres *proximately 25 acre feet JB 6-7-94*

MONTHS OF YEAR DURING WHICH RESERVOIR IS TO BE FILLED
Wintertime the snowmelt, it will be full after that, water flow thru pipes

all year long - during heavy rains thru spillway

NUMBER OF ACRES TO BE IRRIGATED, IF USED FOR IRRIGATION
in case of fire, sprinkles around the house

TYPE AND CAPACITY OF DIVERSION WORKS IF WATER IS TO BE WITHDRAWN

2. LOCATION OF POINT OF DIVERSION OR WITHDRAWAL

ON ACCOMPANYING PLATS OR MAPS, ACCURATELY MARK AND IDENTIFY EACH POINT OF DIVERSION. GIVE MEASURED DISTANCE AND BEARING, OR NORTH-SOUTH AND EAST-WEST DISTANCES FROM NEAREST SECTION CORNER.

COMPLETE EITHER A OR B	A	THE RESERVOIR IS TO BE LOCATED IN THE CHANNEL OF (NAME OF STREAM) no name spring
	B	THE RESERVOIR IS TO BE FILLED THROUGH A FEEDER CANAL (OR PIPELINE) HAVING ITS POINT OF DIVERSION (INTAKE) LOCATED AS FOLLOWS

DISTANCE AND BEARING TO SECTION CORNER
center of the pond 3500 from south from N.W. corner sec. 3

LOCATED WITHIN (SMALLEST LEGAL SUBDIVISION) Lot 2, 21.02 acres	SECTION SEC. 3	TOWNSHIP N. T 32 N	RANGE (E. OR W.) W.M. R 8 E W.M.	COUNTY Snohomish
--	--------------------------	------------------------------	--	----------------------------

3. IF THIS IS WITHIN THE LIMITS OF A RECORDED PLATTED PROPERTY, COMPLETE THIS SECTION

LOT	BLOCK	OF (GIVE NAME OF PLAT OR ADDITION)

4. LOCATION OF IMPOUNDING STRUCTURE

IMPOUNDING STRUCTURE LOCATED WITHIN (SMALLEST LEGAL SUBDIVISION) LOT 2 21.02 acres	SECTION SE 1/4 SEC 3	TOWNSHIP N. T 32 N	RANGE (E. OR W.) W.M. R 8 E W.M.
--	--------------------------------	------------------------------	--

LEGAL SUBDIVISION OF LANDS IN WHICH THE SUBMERGED AREA IS TO BE LOCATED (THE OUTLINE OF THIS LAND IS TO BE SHOWN ON THE MAP TO ACCOMPANY THIS APPLICATION)
LOT 2 21.02 acres lying N of AS-build Road R-0-W

DO YOU OWN THIS PROPERTY <input checked="" type="checkbox"/> YES <input type="checkbox"/> NO	IF NO, HAVE YOU SECURED FLOOD RIGHTS FOR LANDS TO BE INUNDATED <input type="checkbox"/> YES <input type="checkbox"/> NO
---	--

5. CONSTRUCTION OF IMPOUNDING STRUCTURE


HEIGHT OF DAM (FEET) 43'	LENGTH ON TOP (FEET) 235'	LENGTH ON BOTTOM (FEET) 34'	WIDTH ON TOP (FEET) 60'
------------------------------------	-------------------------------------	---------------------------------------	-----------------------------------

SLOPE OF FRONT OR WATER SIDE (NUMBER OF FEET HORIZONTAL TO ONE FOOT VERTICAL) vertical concrete wall

SLOPE OF BACK SIDE (NUMBER OF FEET HORIZONTAL TO ONE FOOT VERTICAL) back 45°

HEIGHT OF DAM ABOVE WATER LINE AT MAXIMUM FLOOD FLOW (FEET) one and half feet

TYPE OF CONSTRUCTION OF DAM AND MATERIAL OF WHICH IT IS TO BE BUILT concrete and dirt

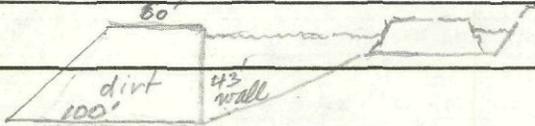

LOCATION AND DIMENSIONS OF SPILLWAYS (STATE WHETHER OVER, AROUND, OR THROUGH DAM)

through pipes 6" and 12", spillway 16 sq' on top based on max 100 year flood, 4 foot pipe 2/3 full

NUMBER OF ACRES TO BE SUBMERGED BY RESERVOIR WHEN FULL 2.75 acres

MAXIMUM DEPTH (FEET) 41

APPROXIMATE AVERAGE DEPTH (FEET) 10

ESTIMATED COST OF PROPOSED WORK \$ 80,000

CONSTRUCTION WILL BEGIN ON OR BEFORE (DATE) June 1992

CONSTRUCTION WILL BE COMPLETED ON, OR BEFORE (DATE) 12.1994

SIZE AND TYPE OF OUTLET STRUCTURE

16 sq. feet on top

6. **LEGAL DESCRIPTION OF PROPERTY ON WHICH WATER IS TO BE USED (IF DIFFERENT THAN ABOVE)**

COPY LEGAL DESCRIPTION FROM DEED; OR ATTACH COPY OF DEED. TAX STATEMENT DESCRIPTIONS ARE NOT ACCEPTABLE. ALSO OUTLINE THIS PROPERTY ON THE MAPS OR PLATS SUBMITTED WITH THIS APPLICATION.

LOT 2 21.06 acres lying N of AS build road R-0-W as discribed on atachet May 1.1991 Survey by Cascade Survey & Ingeneering of N.W 1/4 of the S.E. 1/4 and Gvm. lots 8&10 and N 1/2 of S.W. 1/4 all in sec.3 T 32 N R8E W.M. Snohomish County Washington

DO YOU OWN THIS PROPERTY YES NO

IF NO, GIVE NAME AND ADDRESS OF OWNER

REMARKS

Joey Boyd
SIGNATURE OF APPLICANT

STATE OF WASHINGTON }
DEPARTMENT OF ECOLOGY } ss.

This is to certify that I have examined the foregoing application together with the accompanying maps and data, and return the same for correction or completion as follows:


In order to retain its priority, this application must be returned to the Department of Ecology, with corrections, on or before, 19.....

Witness my hand this *day of*, 19.....

Department of Ecology DEPT OF ECOLOGY



APR 5 1994
RECEIVED

LEE BVID

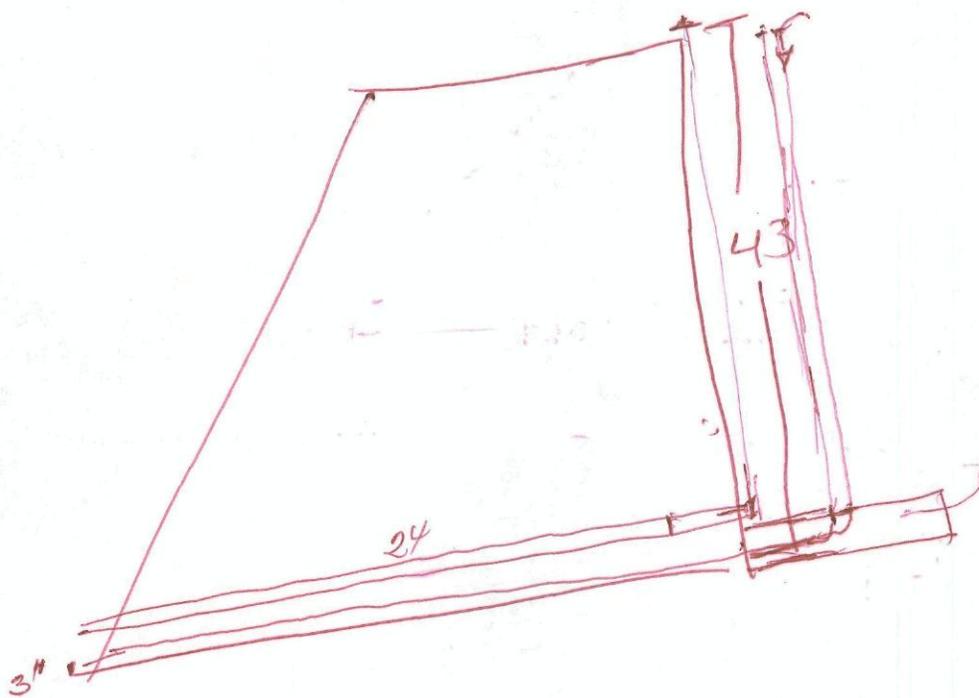

Side

Talked
w/ Dave Cummings

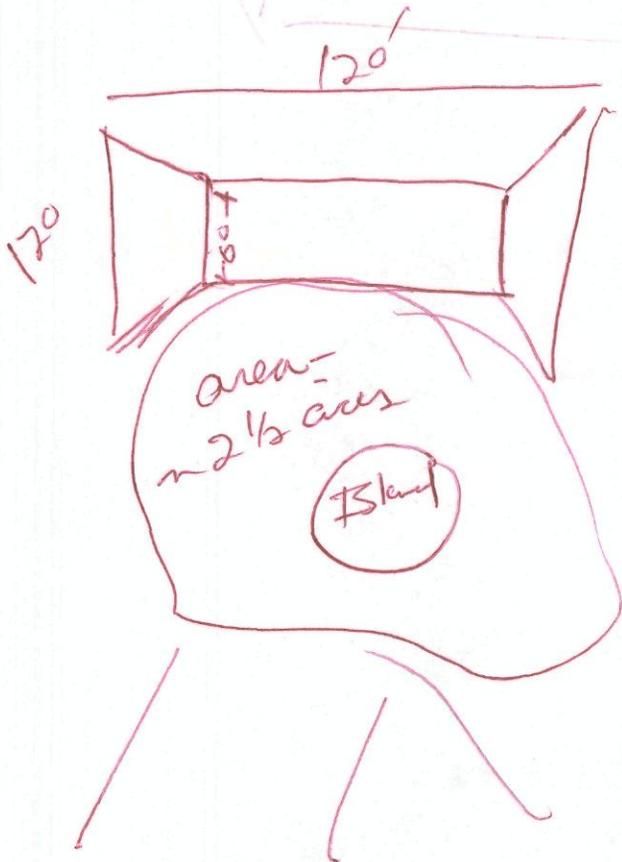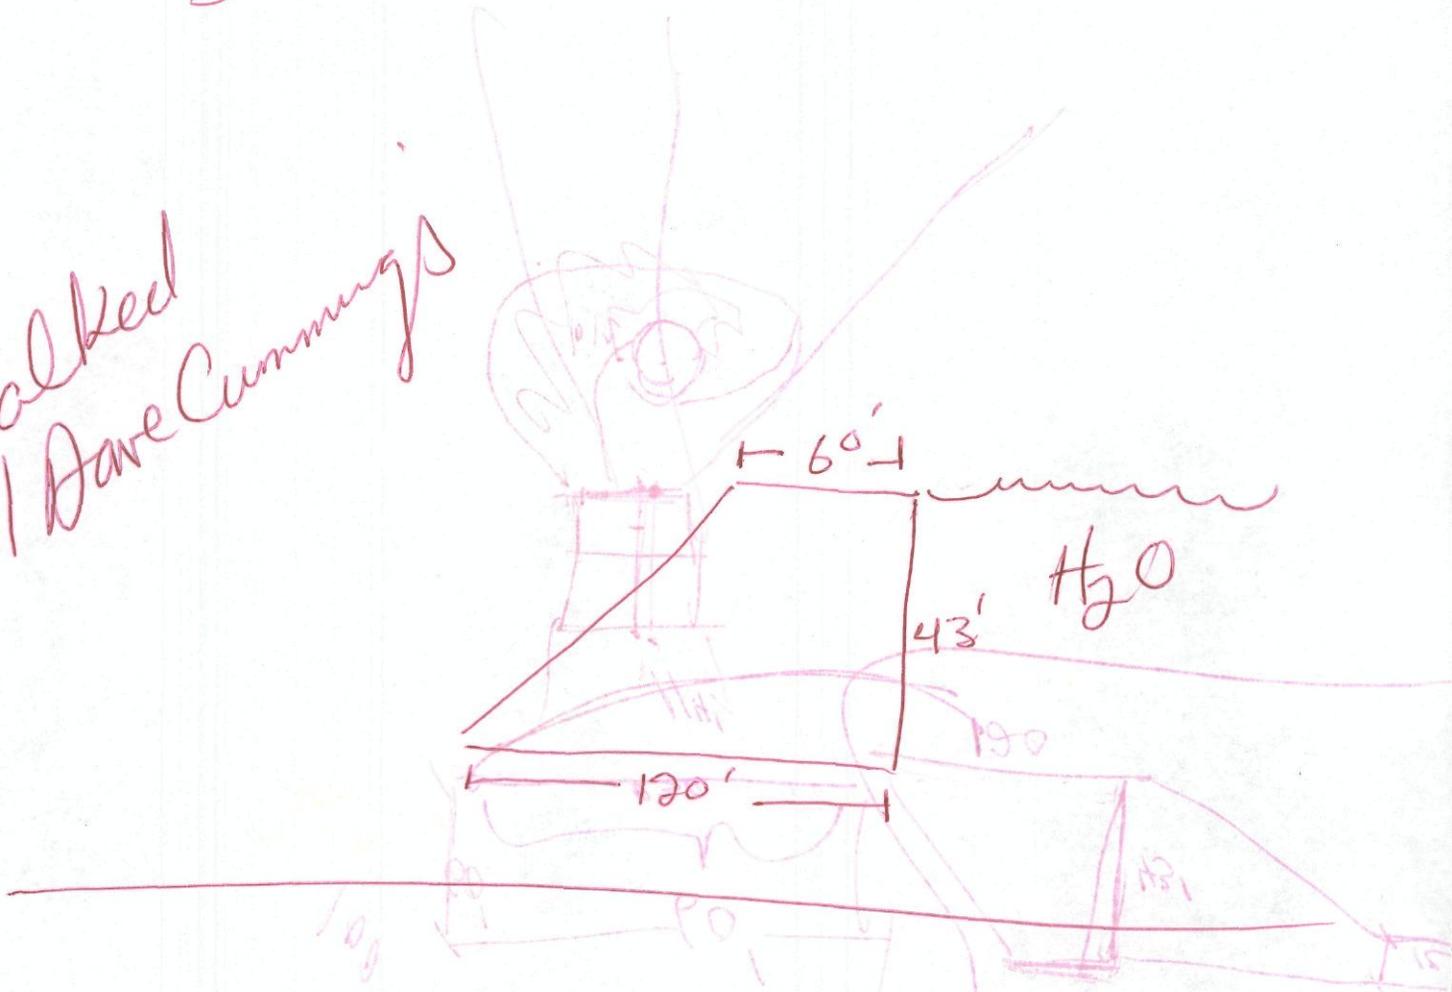


TOP
View

STORAGE
TOTAL =
~ 25 AF



192 HE
 404 HE =
 2405 HE

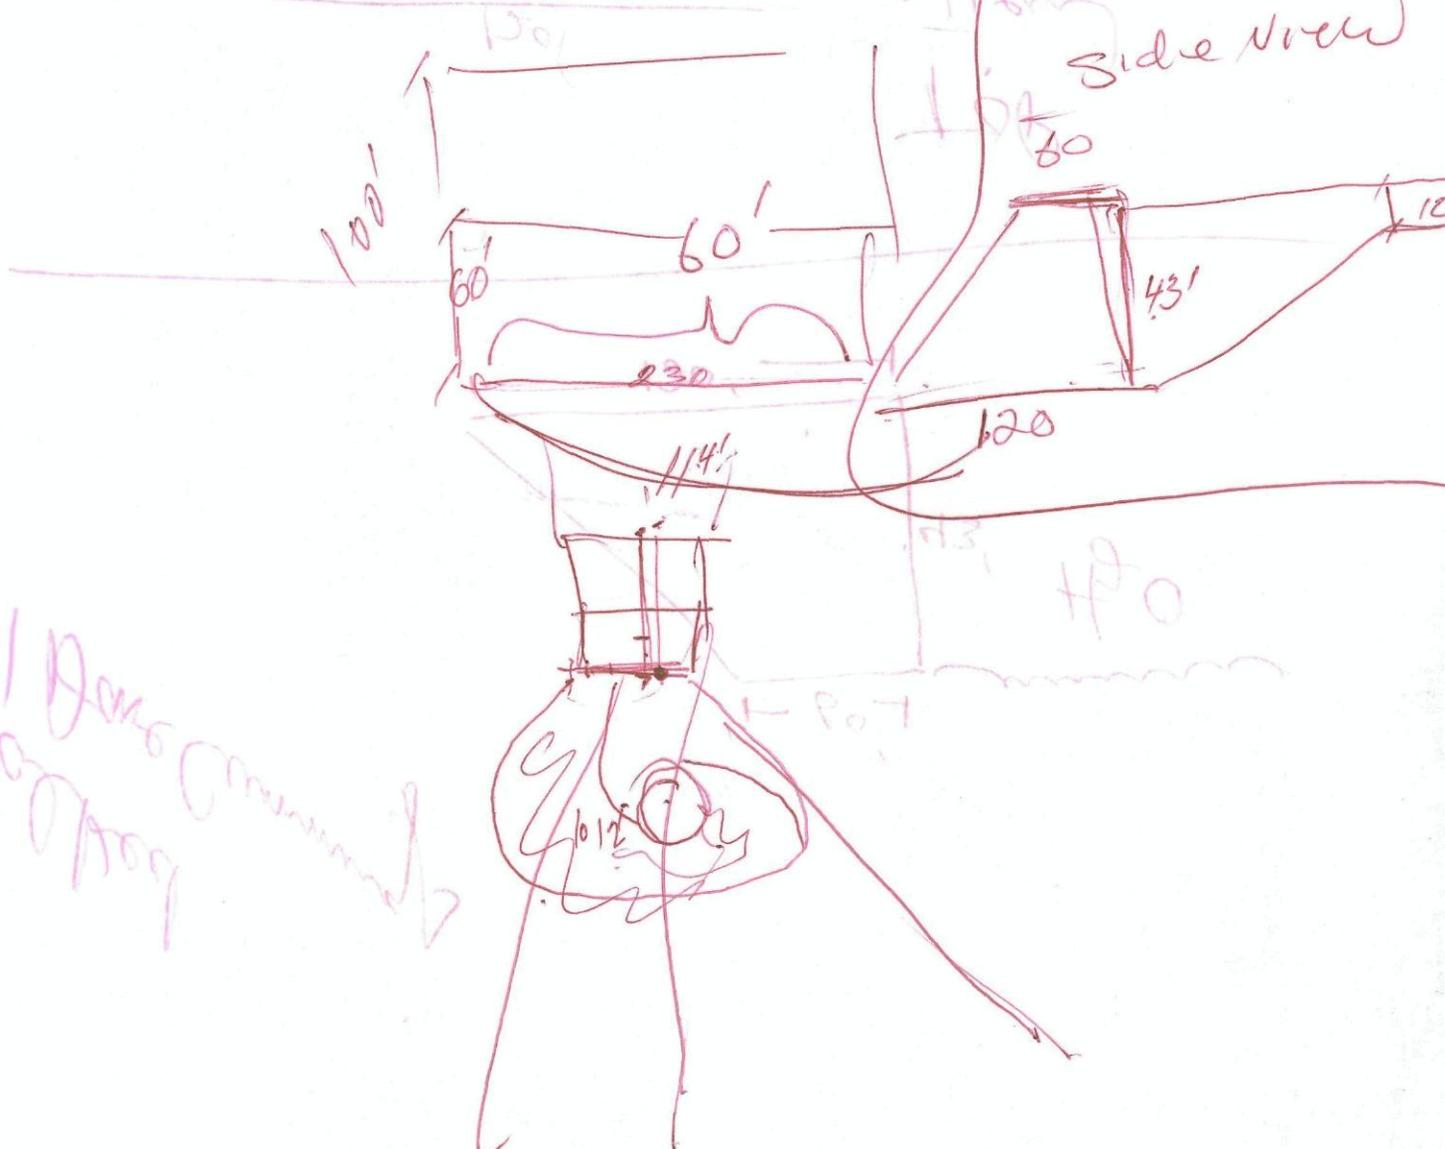

3/1 Dams Command
 10/10/10

2192


☐ CURVE DATA

	Δ	R	L
(A)	79°43'48"	117.00'	162.81'
(B)	79°17'03"	100.00'	138.38'
(C)	125°06'13"	93.00'	203.06'
(D)	16°17'08"	510.50'	145.10'
(E)	97°19'52"	100.00'	169.88'

(F)	11
(G)	29
(H)	15

W 1/4 COR. 3" DIA. ALUM. MON. IN MOUND OF STONE (SET PREVIOUSLY) MARKED AS SHOWN:

B.T.'S FND: NONE B.T.'S SET: 11" CEDAR-584°W-21.30', SCRIBED 1/4 S 4 BT
 10" CEDAR-N 83°E-33.80', SCRIBED 1/4 S 3 BT

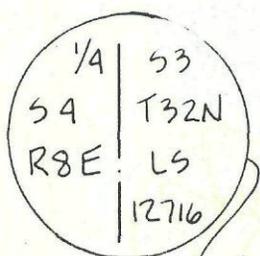


the hill 1000 yards up Spring

No name streams

2607.04'

LOT 2
 21.02 ACRES
 LYING N. OF AS-BUILT
 ROAD R-O-W

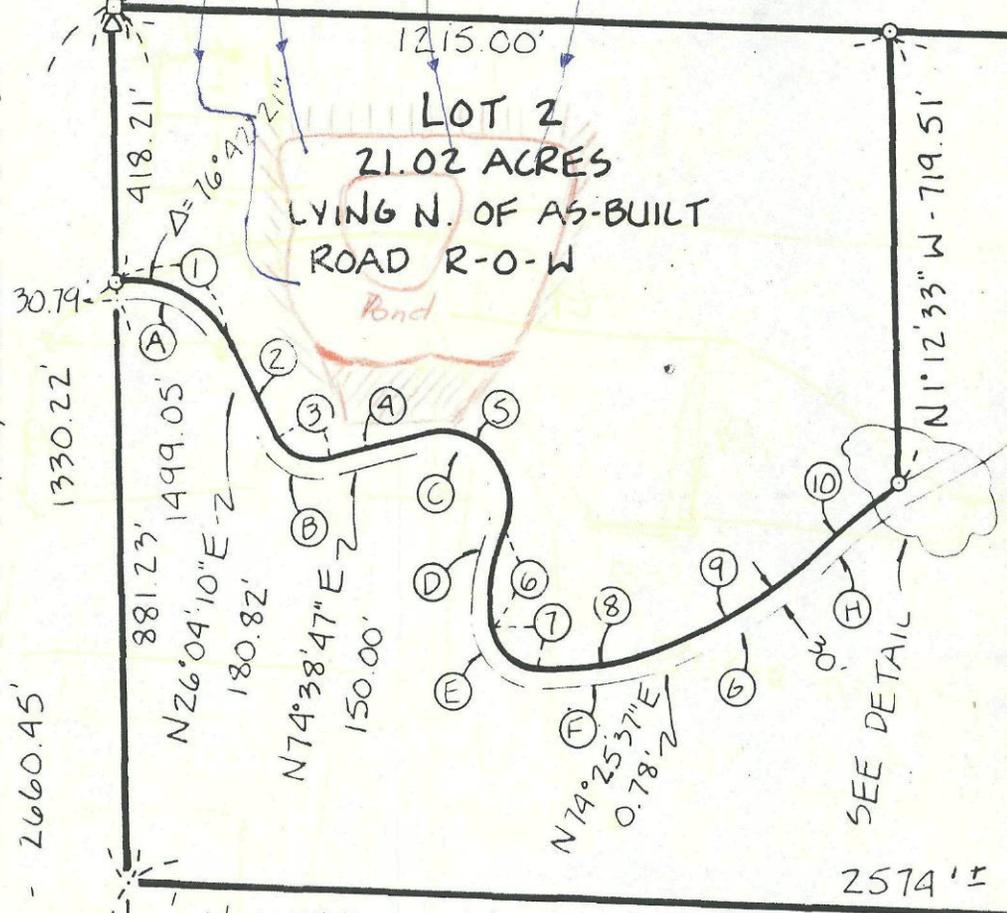


SEE DETAIL

2574' ±

W.C. 3" DIA. ALUM. MON. IN MOUND OF STONE (SET PREVIOUSLY) MARKED AS SHOWN:

B.T.'S FND: NONE B.T.'S SET:
 15" ALDER-589°W-94.70' SCRIBED
 W.C. S 4 BT
 24" CEDAR-558°E-58.42'
 SCRIBED WC S 3 BT

DETAIL
 NTS

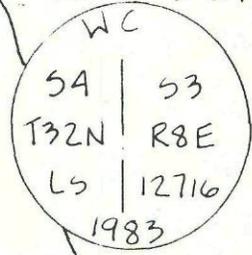

1/4 COR FND 3" DIA. ALUM.
 B.T.'S FND: SPIKE-NE
 SPIKE-NW SIDE 48" CEDAR
 SPIKE-W SIDE 30" CEDAR
 2542.11'

SEC. 4

SEC. 5

SW SEC COR
 CALC'D FROM
 1953 CO TIES

SEC. 10

SEC. 3, T. 32 N., R. 8 E. W.M.

1" = 400'

SEC. 2, T. 32 N., R. 8 E. W.M.

1" = 400'

