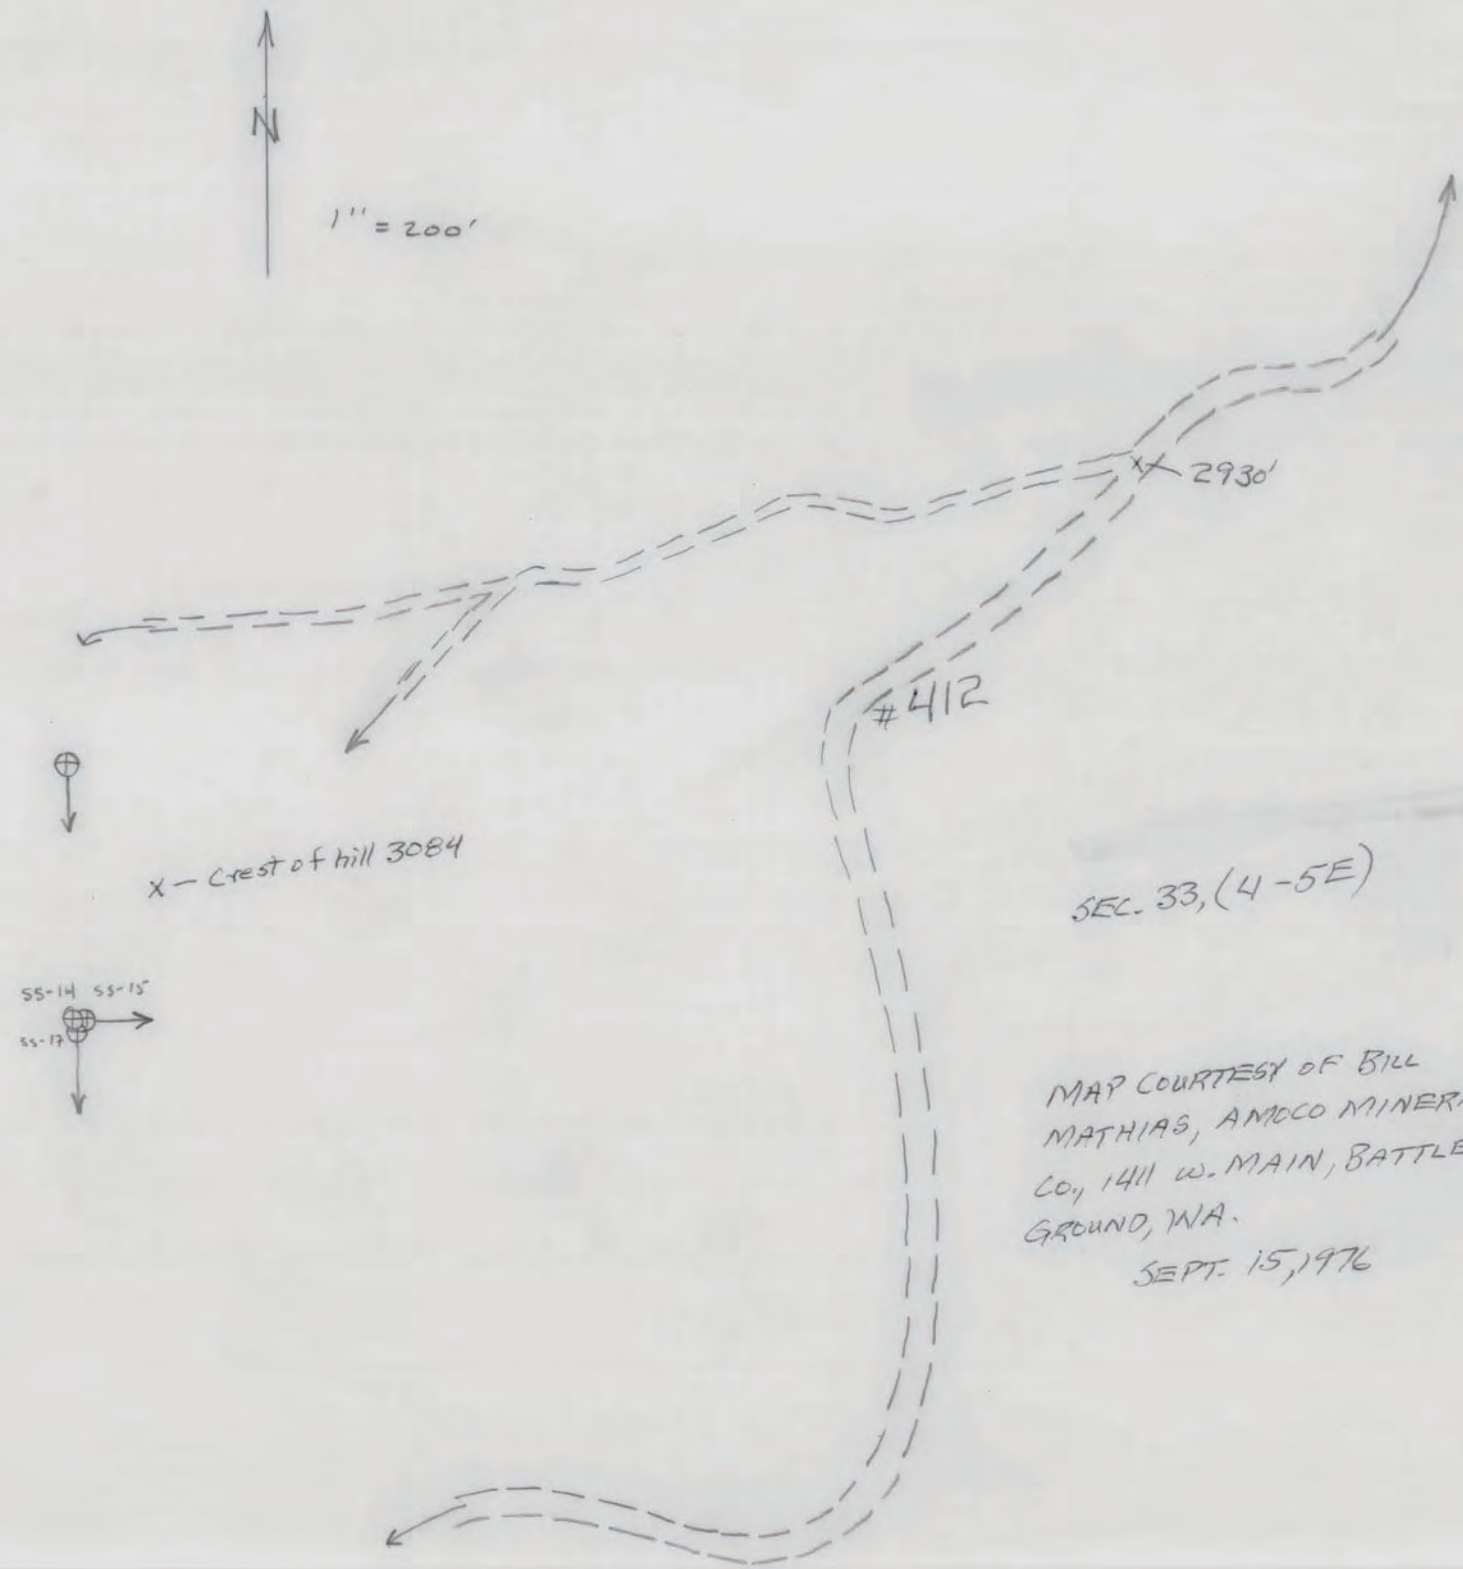

SEC. 33, (4-5E)

MAP COURTESY OF BILL MATHIAS, AMOCO MINERALS CO., 1411 W. MAIN, BATTLE GROUND, WA.

SEPT. 15, 1976

MAP COURTESY OF BILL MATHIAS
AMOCO MINERALS CO, 1411 W. MAIN,
BATTLEGROUND, WA
SEPT. 15, 1976

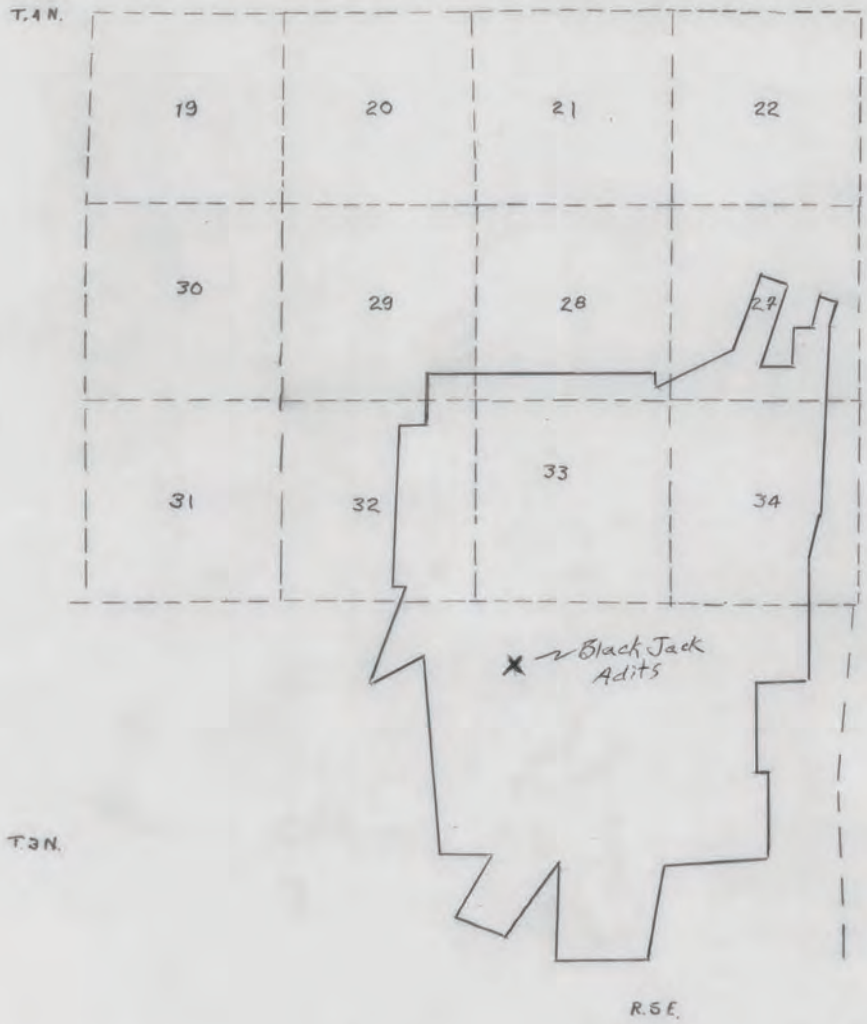

AMOCO CLAIM
BOUNDARIES, SEPT., 1976

LOOKOUT MTN, WASH.
1:62500

THESE HOLES ARE LOCATED IN THE IMMEDIATE VICINITY OF THE MINER'S QUEEN WORKINGS.

MAP COURTESY OF BILL MATHIAS, AMOCO MINERALS CO., 1411 W. MAIN, BATTLEGROUND, WA
SEPT. 15, 1976.

Sec. 4 (3-5E)

MINER'S QUEEN

AMOCO MINERALS CO., MINER'S QUEEN DRILL HOLES, SEC. 4 (3-5E.) & SEC. 33 (4-5E.)

SEE 1"=100' MAP FOR LOCATIONS

HOLE	BRNG	ANGLE	T.D.	START	COMPLETE		
SS-1	—	-90	706'	11 Dec 74	29 Jan 75 ✓		
Blocked — 2	—	-90	1163'	3 Feb. 75	25 Feb 75 ✓		
Water 3	—	-90	966'	27 Feb. 75	15 Mar 75 ✓		
Blocked — 4	—	-90	1027'	18 Mar. 75	10 Apr 75 ✓		
Blocked — 5	—	-90	671'	11 Apr 75	28 Apr 75 ✓		
6	—	-90	707'	1 May 75	16 May 75 ✓		
7	N 90E	-50	1026'	20 May 75	6 Jun 75 ✓		
8			1086'	9 Jun 75	26 Jun 75 ✓	✓	
9	N 90E	-45	950'	26 Jun. 75	21 July 75 ✓		
10	N 90E	-60	785'	18 July 75	29 July 75 ✓		
11	N 90E	-45	1020'	24 July 75	20 Aug. 75 ✓		
Water 12	N 90E	-50	1014'	4 Aug. 75	23 Aug. 75 ✓		
13	N 90E	-45	1200'	25 Aug 75	12 Sept 75 ✓		
ON Hill, sec. 33 (4-5E) 14	—	-90	~~1020~~ 1365	2 Sept 75	10 Sept 75 ✓	✓	ON 3084' HILL
ON Hill, sec. 33 (4-5E) 15	N. 90E	-50	840 ✓	10 Sept. 75	24 Sept 75 ✓		"
16	N 90E	-50	1101	17 Sept. 75	9 Oct. 75 ✓		
ON Hill, sec. 33 (4-5E) 17			462	6 Oct. 75	18 Oct. 75 ✓		"
18	—	-90	1253	15 Oct. 75	5 Nov. 75 ✓		
19	S	-72	1179	21 Oct. 75	7 Nov. 75		
20	—	-90	1237	12 Nov. 75	25 Nov. 75 ✓		
21	—	-90	1000	17 Nov. 75	10 Dec. 75 ✓	✓	
22	—	-90	621	2 Dec 75	19 Dec 75 ✓		
23	—	-90	1145 ~~[illegible]~~	15 Dec 75	19 Dec 75 ✓	✓	
MINER'S QUEEN 24	N 47E	-45	904	16 Jan 76	15 Feb. 76 ✓		
25 a	N 90 E	-50	269	26 Jan. 76	3 Feb. 76		
25 b	N 90 E	-50	690	4 Feb 76	13 Feb 76		
26	N 90E	-50	1010	19 Feb 76	8 Mar. 76		
MINER'S QUEEN 27	N 90E	-45	300	19 Feb 76	26 Feb 76 ✓		
MINER'S QUEEN 28	N 0E	-50	500	27 Feb 76	11 Mar. 76 ✓		
W.P. SC-1	—	-90°	483.7	29 Aug 76	11 Sept. 76		
		Total to date	25,680'				

Chemex Labs Ltd.
212 Brooksbank Ave.
N. Vancouver, B.C. V7J 2C1